OCONEE COUNTY PROCUREMENT OFFICE 415 S. PINE STREET WALHALLA, SC 29691

Tronda C. Popham, CPPB, Procurement Director

Katie Brown, Buyer Telephone: 864-638-4141 Fax: 864-638-4142

ADDENDUM NO. 5

BID NO. 19-04

New Electrical Service for Mobile Mine Duty Crushing Plant for Oconee County Rock Quarry

Bid Date remains: Thursday, September 19, 2019 @ 2:00PM

Please make the following changes:

Remove E-1 and E-2 from the plan / drawing document and replace with E-1 Addendum Revisions 9/13/19 and E-2 Addendum Revisions 9/13/19 (attached with this Addendum No. 5)

This Addendum #5 includes answers to the following question(s) and/or clarification(s) from Oconee County. *A signed copy of this Addendum #5 must also be returned with your bid.*

1. **Question:** Who is responsible for installing the insulation in the container?

Answer: The Contractor will install the insulation in the container as indicated on the drawings.

2. **Question:** Who is responsible for installing the container?

Answer: The County will install the container, including the pad and required

anchoring.

3. **Question:** Who is responsible for transformer pad?

Answer: The County will provide the transformer pad.

4. **Question:** What is the distance from the transformer to the container?

Answer: No more than 20'

5. Question: Can an E-Stop be placed on the outside of the container in lieu of the

disconnect switches so that there will be enough room to mount the

receptacles feeding the equipment.

Answer: The Engineer has revised drawings / specifications, see updated container

layout in Addendum Revisions 9/13/19 (attached with this Addendum No. 5).

6. **Question:** Is a certified rigger required?

Answer:

Answer:

The contractor will be responsible for placing the switchboard within the container. The manufacturer of the switchboard may have requirements for moving the switchboard into position which the contractor should adhere to. If the contractor is not qualified or experienced in moving the switchboard as required, then he should subcontract this work out to someone who is qualified.

7. **Question:** Will the County assist in required trenching?

Prior to installing the transformer pad, the County will dig a trench from the pad location to the container for the contractor to install the transformer secondary conduits. The County will then backfill the trench. The service from the transformer over to the shipping container should be brought into the container through the wall behind the switchgear and not underneath since the container will be moveable. LB's should be provided coming out of the back wall and connected to rigid galvanized steel conduit via flexible metal conduit. Oconee County will also trench for the buried grounding around the container.

8. **Question:** Will the County accept "equal" for the Anaconda cabling?

The cable has been changed from a 3-conductor cable with a ground to a 4-conductor cable with a ground. As such the new cable is specified as a Southwire Rhinoflex cable on revised Dwg. E-1. The bidder shall submit their bid using the Southwire cabling as specified. The bidder may submit an equal as an alternate during the bids for final approval by the engineer. They will need to include the cost difference along with the specifications of the "equal" cabling.

9. **Question:** Will equals for the switchboard be allowed?

Answer: Equals by Eaton/Cutler Hammer, G.E., and Siemens are acceptable.

10. **Question:** Will you need a GC licensed contractor for this project?

Answer: No, since Oconee County is installing the shipping container, a General Contractor will not be necessary.

11. **Question:** Will the trailing cables be hard wired into the disconnects and equipment or are you wanting receptacles like we discussed in the pre-bid meeting on 7-8-19?

Answer: Per a phone conversation between Thom Moxley (Oconee County) and Chris Mahaffey (Burdette Engineering) following the meeting, the exterior disconnect switches will not be required. Receptacles shall be fed directly from the circuit breakers in the switchboard. These receptacles shall be located on the side of the shipping container and will need to be mounted in Nema 3R boxes per each circuit. All receptacles shall be Cavotec # PC6-VX05-1500 and all plugs shall be Cavotec # PC6-SX05-1500. The first 1200 Amp circuit will utilize three (3) each of the socket/plug combination factory

painted Orange, the second 1200 Amp circuit will utilize three (3) each of the socket/plug combination factory painted Yellow, the 800 Amp circuit will utilize two (2) each of the socket/plug combination factory painted Red, the first 400 Amp circuit will utilize one (1) of the socket/plug combination factory painted Blue, and the remaining 400 Amp circuit will utilize one (1) of the socket/plug combination factory painted Green. The equipment end of the cables shall be hardwired to the equipment.

12. **Question:** It's my understanding that MSHA requires a 7ft fence around the transformer.

Please clarify if the fence installation is the contractor's responsibility.

Answer:

MSHA §56.12067 Installation of transformers states, "Transformers shall be totally enclosed, or shall be placed at least 8 feet above the ground, or installed in a transformer house, or surrounded by a substantial fence at least 6 feet high and at least 3 feet from any energized parts, casing, or wiring." The transformer that Blue Ridge Electric installs should be a totally enclosed transformer with no exposed energized parts; therefore, a fence is not required. In the event that it is decided that a fence is needed, Oconee County will furnish and install the fence.

13. **Question:** Please provide the inside dimensions of the shipping container.

Answer:

It appears that the standard width and height of shipping containers is 7'-8" wide by 7'-9" high. Per the Invitation to bid, a 20' container is being purchased by the county and the inside dimension will be 19'-5". This should be verified with the actual container that the Rock Quarry purchases.


14. **Question:** Is Oconee County Rock Quarry Tax Exempt?

Answer:

Yes, Oconee County Rock Quarry is exempt from tax on anything used in the production of the product (rock). A tax exempt certificate will be provided to the awarded contractor.

END ADDENDUM NO. 5

Dated: 9-13-19		
Please acknowledge receipt of A	ddendum by signing and attaching to your bid.	
BY:(Contractor)	DATE:	
(Signature)	(Title of Signing Officer)	

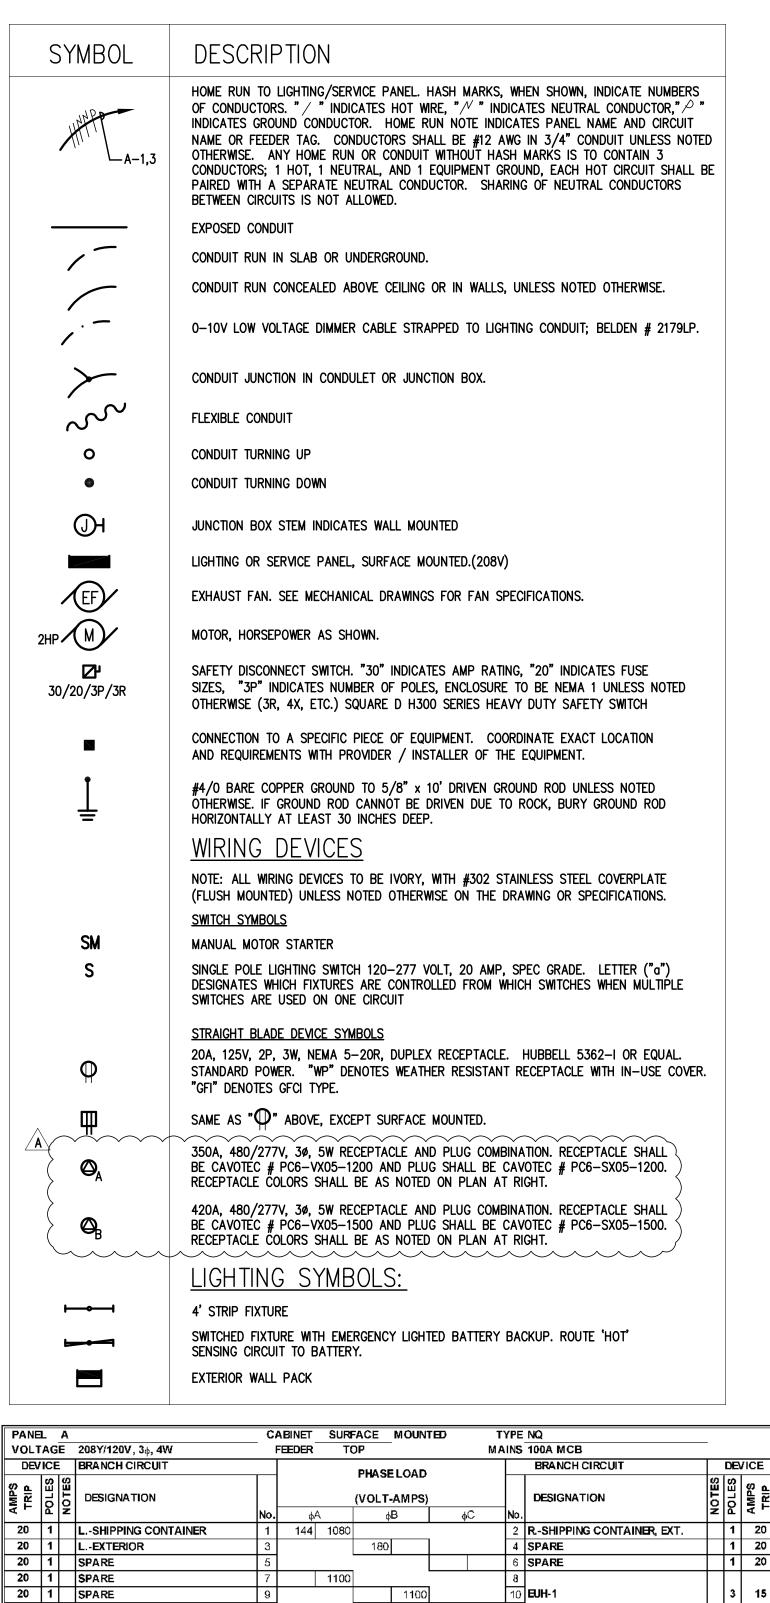

20 1 SPARE 20 1 SPARE

20 1 SPARE 20 1 SPARE

1 SPACE 1 SPACE

1 SPACE 1 SPACE 1 SPACE 1 SPACE INTEGRATED EQUIPMENT RATING: 10KAIC

FIXTURE

SAME AS " Φ " ABOVE, EXCEPT SURFACE MOUNTED.	WP/GFI WPE/					WPE/ A-3	
350A, 480/277V, 3Ø, 5W RECEPTACLE AND PLUG COMBINATION. RECEPTACLE SHALL BE CAVOTEC # PC6-VX05-1200 AND PLUG SHALL BE CAVOTEC # PC6-SX05-1200. RECEPTACLE COLORS SHALL BE AS NOTED ON PLAN AT RIGHT.	20"Hx16"Wx10" NEMA 3R BOX		24"Hx36"Wx10"D NEMA 3R	24"Hx36"Wx10"D NEMA 3R	B B B 30"Hx24"Wx10"D	(S2500)	
420A, 480/277V, 3ø, 5W RECEPTACLE AND PLUG COMBINATION. RECEPTACLE SHALL SE CAVOTEC # PC6-VX05-1500 AND PLUG SHALL BE CAVOTEC # PC6-SX05-1500.	MTH (1) 420A GREEN RECEPTA	WITH (1) 420A	BOX WITH (3) 350A YELLOW RECEPTACLES FOR 1000A CRUSHER MC3	BOX WITH (3) 350A ORANGE RECEPTACLES FOR 1000A CRUSHER MC2	NEMA 3R BOX WITH (2) 420A RED RECEPTACLES FOR	MOUNT CORMER	
RECEPTACLE COLORS SHALL BE AS NOTED ON PLAN AT RIGHT.	FOR 400A SCREENING MS	FOR 400A	TON TOOM SKOOTIEN INCO	TON TOOM SHOOMEN MOE	800A CRUSHER MC1	CABLE/COM	NDUIT SCHEDULE
LIGHTING SYMBOLS:	SOCIETINO WS				AVOLIT	TAG	WRE AND CONDUIT
4' STRIP FIXTURE	($\frac{A}{E-1} \frac{E}{1/2} = 1'-0''$	JAL SHIPPING	CONTAINER L	<u>-A 100 I</u>	45	3 #8, 1 #10G; 3/4°C
SWITCHED FIXTURE WITH EMERGENCY LIGHTED BATTERY BACKUP. ROUTE 'HOT' SENSING CIRCUIT TO BATTERY.			2 0	2 4	6	4/C-500 RHINOFLE	OKCMIL WITH 4#1/0G, TYPE G, SOUTHWIRE EX CPE MINING CABLE, 90°C, SPEC 47208
EXTERIOR WALL PACK	PRIMARY BY			1/2" = 1'-0"		3 SEIS [4/U	C-500KCMIL WITH 4#1/0G, TYPE G, SOUTHWRE EX CPE MINING CABLE, 90°C, SPEC 47208]
	ELECTRIC UTILIT	Y				(400WC) }	4 #600KCMIL, 1 #3G; 3 1/2°C
CABINET SURFACE MOUNTED TYPE NQ FEEDER TOP MAINS 100A MCB BRANCH CIRCUIT DEVICE]				700WC \	2 [4 #500KCMIL, 1 #1/0G; 3"C]
PHASE LOAD (VOLT-AMPS) No. dA dB dC No.	ایلیا	NEW BLUE RIDGE ELECTR UTILITY TRANSFORMER W	RIC CO-OP			(1000WC) 3	[4 #500KCMIL, 1 #3/0G; 3 1/2"C]
No.	M	480/277V, 3ø, 4W SECO				N100	4 #3, 1 #8G; 1 1/4"C
3 180 4 SPARE 1 20 5 6 SPARE 1 20		J				S2500	6 [4 #600KCMIL; 4"C]
7 1100 8 8 EUH-1 3 15 1100 12 1100 12 15 15 2486 16 ODU-1	S2500			PROTECTION FOR EQUIPMENT AND	AN ENERGY-REDUCING MAINTEN	NANCE SWITCH WITH LOCKOUT ON	65KAIC FULLY RATED. INCLUDE GROUND-FAULT N THE FRONT OF THE SWITCHBOARD FOR EACH , OR G.E. ARE ACCEPTABLE MANUFACTURERS.
17 18 SPARE 1 20				OINCOTT BREAKER KATED 1200 AI	WI 3 OK MOHER. SQUARE D, EA	TIONY COTELIC TIAMMEN, SIEMENS,	ON G.E. AND AGGETTABLE WANTON ACTURENS.
19 20 SPACE 1	ELECTRONIC	_	1	2 3	4 5	6 7	8 9
23 24 SPACE 1 25 26 SPACE 1	METERING	Ŝ _{\ MAIN}		ô \\\\ 1200AF\\\\\\\\\\\\\\\\\\\\\\\\\\\\\\\\\\\) 400AF		REPARED PREPARED PREPARED
27 28 SPACE 1 1 29 30 SPACE 1	1		EGRAL 9 700AT	1000AT (1000AT 3P)	$\left(\begin{array}{ccc} Q \end{array}\right) \begin{array}{ccc} 400AT & Q \end{array} \begin{array}{ccc} 400A \\ 3P \end{array}$		DOA 400A 100A PACE SPACE SPACE
KVA TOTAL 4.8 3.8 1.1 PANEL BOARD KVA LOAD TOTAL: 9.7			SPD LSIG	LSIG 100% RATED 100% RA	TED	Y	ΥΥΥ
1#3/0g, 1"C TO BLDG. STEEL AND GROUND LOOP PER NEC 250. SINGLE LINE NOTES: 1. IN ADDITION TO ON DWG. E-2, FOR THE DIPS E 2. IN ADDITION TO ON DWG. E-2, FOR THE DIPS E 3. IN ADDITION TO ON DWG. E-2,	THE LENGTH OF CABLE REQUIRED FOR PROVIDE AN ADDITIONAL 15 FEET OF BETWEEN SUPPORTS AND ATTACHMEN THE LENGTH OF CABLE REQUIRED FOR PROVIDE AN ADDITIONAL 25 FEET OF BETWEEN SUPPORTS AND ATTACHMEN THE LENGTH OF CABLE REQUIRED FOR PROVIDE AN ADDITIONAL 50 FEET OF BETWEEN SUPPORTS AND ATTACHMEN BETWEEN SUPPORTS AND ATTACHMEN	SLACK CABLE TO ALLOW IS TO EQUIPMENT. R THE ROUTING SHOWN SLACK CABLE TO ALLOW IS TO EQUIPMENT. R THE ROUTING SHOWN SLACK CABLE TO ALLOW	700WC (2)B QUANTITY (TYP.) SPARE FOR CRUSHER MC1	(3)A (3)A (3)A (3)A SEE NOTE 1. SEE NOTE	400WC 400 B B B	30KVA 480-208/120V, 3ø, 4W	LDG. STEEL UND ROD.

GENERAL LIGHTING NOTES:

BEFORE SUBMITTING FIXTURE.

DIMMING DRIVER

TYPE

SUBMITTAL DATA, PHOTOMETRICS & ENGINEERS APPROVAL AS REQUIRED BY SPECIFICATIONS.

EXTERIOR LED WALL PACK WITH DIE-CAST ALUMINUM DECO # D402-LED-60-40-U-BZ-Q-TE

<u>IDU-2</u>

3. PROVIDE ALL MOUNTING ACCESSORIES, BAR HANGARS & HARDWARE REQUIRED.

MANUFACTURER SHALL BE BODINE OR APPROVED EQUAL.

FIXTURE DESCRIPTION

4', LED CHANNEL STRIP LIGHT, STEEL HOUSING,

SAME AS 'IA' ABOVE EXCEPT PROVIDED WITH

GASKETED HOUSING, BOROSILICATE GLASS LENS,

PHOTOCELL. AND EMERGENCY BATTERY BACKUP.

UNIVERSAL VOLTAGE, DARK BRONZE FINISH,

EMERGENCY BATTERY BACKUP.

FROSTED ACRYLIC LENS, WHITE FINISH, PAF, 0-10V

. MANUFACTURERS & NUMBERS ARE LISTED TO ESTABLISH QUALITY ONLY AND NOT TO LIMIT COMPETITION. PRIOR TO BIDDING, SUBSTITUTIONS ARE ALLOWED SUBJECT TO

H. EMERGENCY BATTERIES SHALL PROVIDE A MINIMUM OF 1100 LUMEN OUTPUT. BATTERIES SHALL CONTAIN INTEGRAL SENSING CIRCUIT TO ALLOW FIXTURE TO BE SWITCHED

LITHONIA # ZL1D-L48-5000LM-FST-MVOLT-35K-80CRI-WH

LITHONIA # ZL1D-L48-5000LM-FST-MVOLT-35K-80CRI-E7W-WH

ACCEPTABLE MANUFACTURERS

MOUNTING

30/FU/2P/3R-7

2#10, 1 #10G; 3/4"C

<u>IDU-1</u>

PROVIDE INSULATING FLOOR MAT FOR

ENTIRE LENGTH OF SWITCHBOARD.

DISTRIBUTION

WPE

HEIGHT

NOMINAL

5000 LUMEN

LED PANEL

3500K

NOMINAL

5000 LUMEN

LED PANEL

3500K

NOMINAL

6300 LUMEN

LED PANEL

4000K

INCOMING LINE

<u>ODU-1</u>

A-8/10/12-

MAIN SWITCHBOARD 'MSB'

DISTRIBUTION

FIXTURE

WATTAGE

VOLTAGE

UNIVERSAL

VOLTAGE

UNIVERSAL

VOLTAGE

UNIVERSAL

VOLTAGE

2. ALL FIXTURES TO BE U.L. LABELED. ALL EXTERIOR FIXTURES SHALL HAVE U.L. WET LABEL OR DAMP LABEL AS REQUIRED BY LOCATION. CONTRACTOR SHALL VERIFY

WITH AREA FIXTURES FOR NORMAL OPERATION AND ENERGIZE BATTERY POWERED FIXTURE UPON LOSS OF POWER CIRCUIT, REGARDLESS OF SWITCH POSITION.

LIGHTING FIXTURE SCHEDULE

LSI # SDL-4-LED-HO-WW-UE

COLÜMBIA # LCL4-35-ML-EDU-PAF

LSI # SDL-4-LED-HO-WW-UE-EM

wP/GFI∰

TYPICAL FOR

BOTH UNITS.-

COLÜMBIA # LCL4-35-ML-EDU-PAF-ELL14

DURAGUARD # LWPQ-F-1X58-U-4K-Z-PC3-BU

ABBREVIATIONS:

- **AFF** ABOVE FINISHED FLOOR **AFG** ABOVE FINISHED GRADE
- **BKR** BREAKER CU COPPER
- CKT CIRCUIT **DWG** DRAWING FU FUSE
- FWE FURNISHED WITH EQUIPMENT
- GROUND FAULT INTERRUPTER DEVICE LIGHTING (L.)
- LTG MLO MAIN LUGS ONLY
- MCB MAIN CIRCUIT BREAKER
- MSB MAIN SWITCHBOARD PH PHASE
- PNL PANEL PVC POLYVINYL CHLORIDE CONDUIT
- **RECPT** RECEPTACLE (R.)
- RGS RIGID GALVANIZED STEEL SPD SURGE PROTECTIVE DEVICE

- CONTRACTOR SHALL FURNISH AND INSTALL INSOFAST

CX44 SHIPPING CONTAINER INSULATION ON WALLS AND

EQUIVALENT PRODUCT BY INSOFAST ON CEILING AND

DOORS IN ORDER TO ACHIEVE AN R11 INSULATION

RATING. FOLLOW MANUFACTURER'S INSTRUCTIONS FOR

INSTALLATION OF INSULATION AND MOUNTING OF

RECEPTACLES, SWITCH, LIGHTING, AND PANELBOARD.

- TYP TYPICAL
- **WP** WEATHER PROOF **XFMR** TRANSFORMER


ELECTRICAL GENERAL NOTES:

- INSPECT SITE PRIOR TO SUBMITTING BID. DRAWINGS ARE INTENDED TO COVER THE REQUIRED ELECTRICAL SYSTEMS. DRAWINGS MAY NOT SHOW COMPLETE OR ACCURATE DETAILS OF THE BUILDING OR SYSTEM IN EVERY RESPECT. I IS THE RESPONSIBILITY OF THE CONTRACTOR TO OBTAIN ANY ADDITIONAL INFORMATION AS REQUIRED.
- CONFORM TO THE NATIONAL ELECTRICAL CODE (2014), IBC (2015), IECC (2009). APPLICABLE NEMA. ANSI AND IEEE PUBLICATIONS, U.L. AND ADA STANDARDS AND OSHA REQUIREMENTS. COMPLY WITH LOCAL, COUNTY, STATE AND NATIONAL CODES HAVING JURISDICTION.
- FURNISH AND INSTALL ALL MATERIALS IN A NEAT AND WORKMANLIKE FASHION. ALL MATERIALS SHALL BE NEW, WITH FIRST QUALITY AND UL
- VERIFY ALL DIMENSIONS AND CLEARANCES PRIOR TO INSTALLATION OF EQUIPMENT AND RACEWAYS. CONTRACTOR IS RESPONSIBLE FOR COORDINATION OF WORK WITH THAT OF ALL OTHER TRADES AS REQUIRED.
- CONDUIT SHALL BE RIGID GALVANIZED STEEL. MINIMUM CONDUIT SIZE SHALL BE 3/4". ALL CONDUCTORS SHALL BE TYPE THHN/THWN, STRANDED 600V COPPER BUILDING WIRE. MINIMUM SIZE SHALL BE #12 AWG COPPER UNLESS NOTED. UNDERGROUND CONDUITS SHALL BE PVC SCHEDULE 40 WITH TRANSITION TO RIGID GALVANIZED STEEL FOR EXPOSED CONDUITS.
- PROVIDE GROUNDING FOR ALL EQUIPMENT IN ACCORDANCE WITH ARTICLE 250 OF THE NATIONAL ELECTRICAL CODE. GROUND SERVICE TO BUILDING STEEL. DRIVEN GROUND ROD AND COLD WATER PIPE.
- ALL ENCLOSURES SHALL BE OF THE NEMA TYPE WHICH IS SUITABLE FOR THE
- 8. SEAL ALL CONDUIT PENETRATIONS.


APPLICATION.

- ALL WORK SHALL HAVE PROPER LABELING AND NAMEPLATES. ALL CIRCUITS SHALL BE LABELED AT PANELS AND BOXES AS INDICATED. ALL PANELS AND DISCONNECTS ARE TO BE PERMANENTLY MARKED WITH NAME OR EQUIPMENT SERVED. ALL PANELS ARE TO BE PROVIDED WITH TYPEWRITTEN PANEL SCHEDULES.
- 10. ALL BREAKERS ON CIRCUITS SUPPLYING HVAC EQUIPMENT SHALL BE TYPE
- COORDINĂTE WITH ELECTRICAL UTILITY AS REQUIRED FOR SERVICE ENTRY. OCONEE COUNTY WILL INSTALL CONCRETE PAD AND PROVIDE TRENCH FOR CONDUIT. CONTRACTOR SHALL INSTALL METER AND CONDUITS PER UTILITY REQUIREMENTS AND PAY ALL REQUIRED FEES OR CHARGES FOR SERVICES
- 12. THOROUGHLY CLEAN ALL EQUIPMENT AND SYSTEMS BEFORE PLACING IN OPERATION. RESTORE FINISHED SURFACES IF DAMAGED AND DELIVER THE ENTIRE INSTALLATION IN AN APPROVED CONDITION. INSTRUCT THE OWNERS' PERSONNEL IN THE PROPER OPERATION AND MAINTENANCE OF THE SYSTEMS. FURNISH TO THE OWNER THREE SETS OF OPERATION AND MAINTENANCE MANUALS FOR EACH SYSTEM.
- 13. GUARANTEE THE WORK INSTALLED FOR A PERIOD OF ONE YEAR AFTER DATE OF FINAL ACCEPTANCE. DEFECTS WHICH APPEAR AS A RESULT OF NORMAL USAGE SHALL BE REMEDIED BY THE CONTRACTOR TO THE COMPLETE SATISFACTION OF THE OWNER WITHOUT COST TO THE OWNER.
- CONTRACTOR SHALL KEEP CURRENT A SET OF PLANS FOR THE DURATION OF CONSTRUCTION WITH ALL CHANGES TO WORK NEATLY AND ACCURATELY MARKED IN RED AND SHALL TURN OVER TO OWNER AT COMPLETION OF
- 15. ALL ELECTRICAL EQUIPMENT SHALL BE INSTALLED TO MEET SEISMIC REQUIREMENTS OF 2015 IBC.
- 16. GROUND-FAULT PROTECTION OF EQUIPMENT SHALL BE PROVIDED FOR 480 VOLT SERVICES FOR EACH SERVICE DISCONNECT RATED 1000 AMPS OR MORE
- 17. ALL PANELBOARDS SHALL BE FURNISHED WITH COPPER BUS BARS AND A COPPER GROUNDING BUS BAR.
- 18. POWER WIRES AND CABLES SHALL BE INSULATED ADEQUATELY WHERE THEY PASS INTO OR OUT OF ELECTRICAL COMPARTMENTS. CABLES SHALL ENTER METAL FRAMES OF MOTORS, SPLICE BOXES, AND ELECTRICAL COMPARTMENTS ONLY THROUGH PROPER FITTINGS. WHEN INSULATED WIRES, OTHER THAN CABLES, PASS THROUGH METAL FRAMES, THE HOLES SHALL BE SUBSTANTIALLY BUSHED WITH INSULATED BUSHINGS.
- 19. CONTRACTOR SHALL FURNISH A COMPLETE ARC-FLASH AND CIRCUIT BREAKER COORDINATION STUDY AND SET CIRCUIT BREAKERS ACCORDINGLY AND INSTALL ARC-FLASH LABELS PER N.E.C. CONTRACTOR IS RESPONSIBLE FOR GATHERING ALL INFORMATION REQUIRED FOR THE STUDIES.

TYPICAL DEVICE MOUNTING HEIGHT

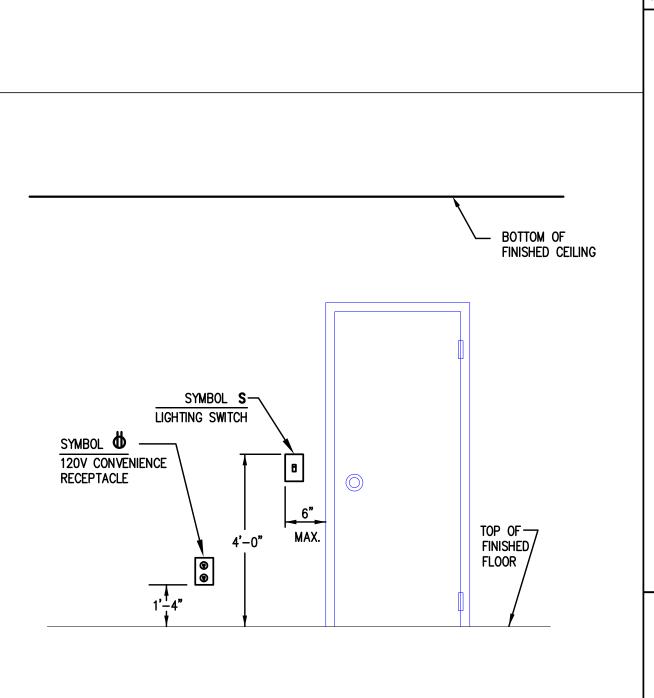



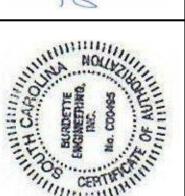




CRUSHING COUNTY OCONEE MOBILE WALHALLA, SC

SHEET NUMBER

1 OF 3 SHEETS

B SINGLE LINE DIAGRAM

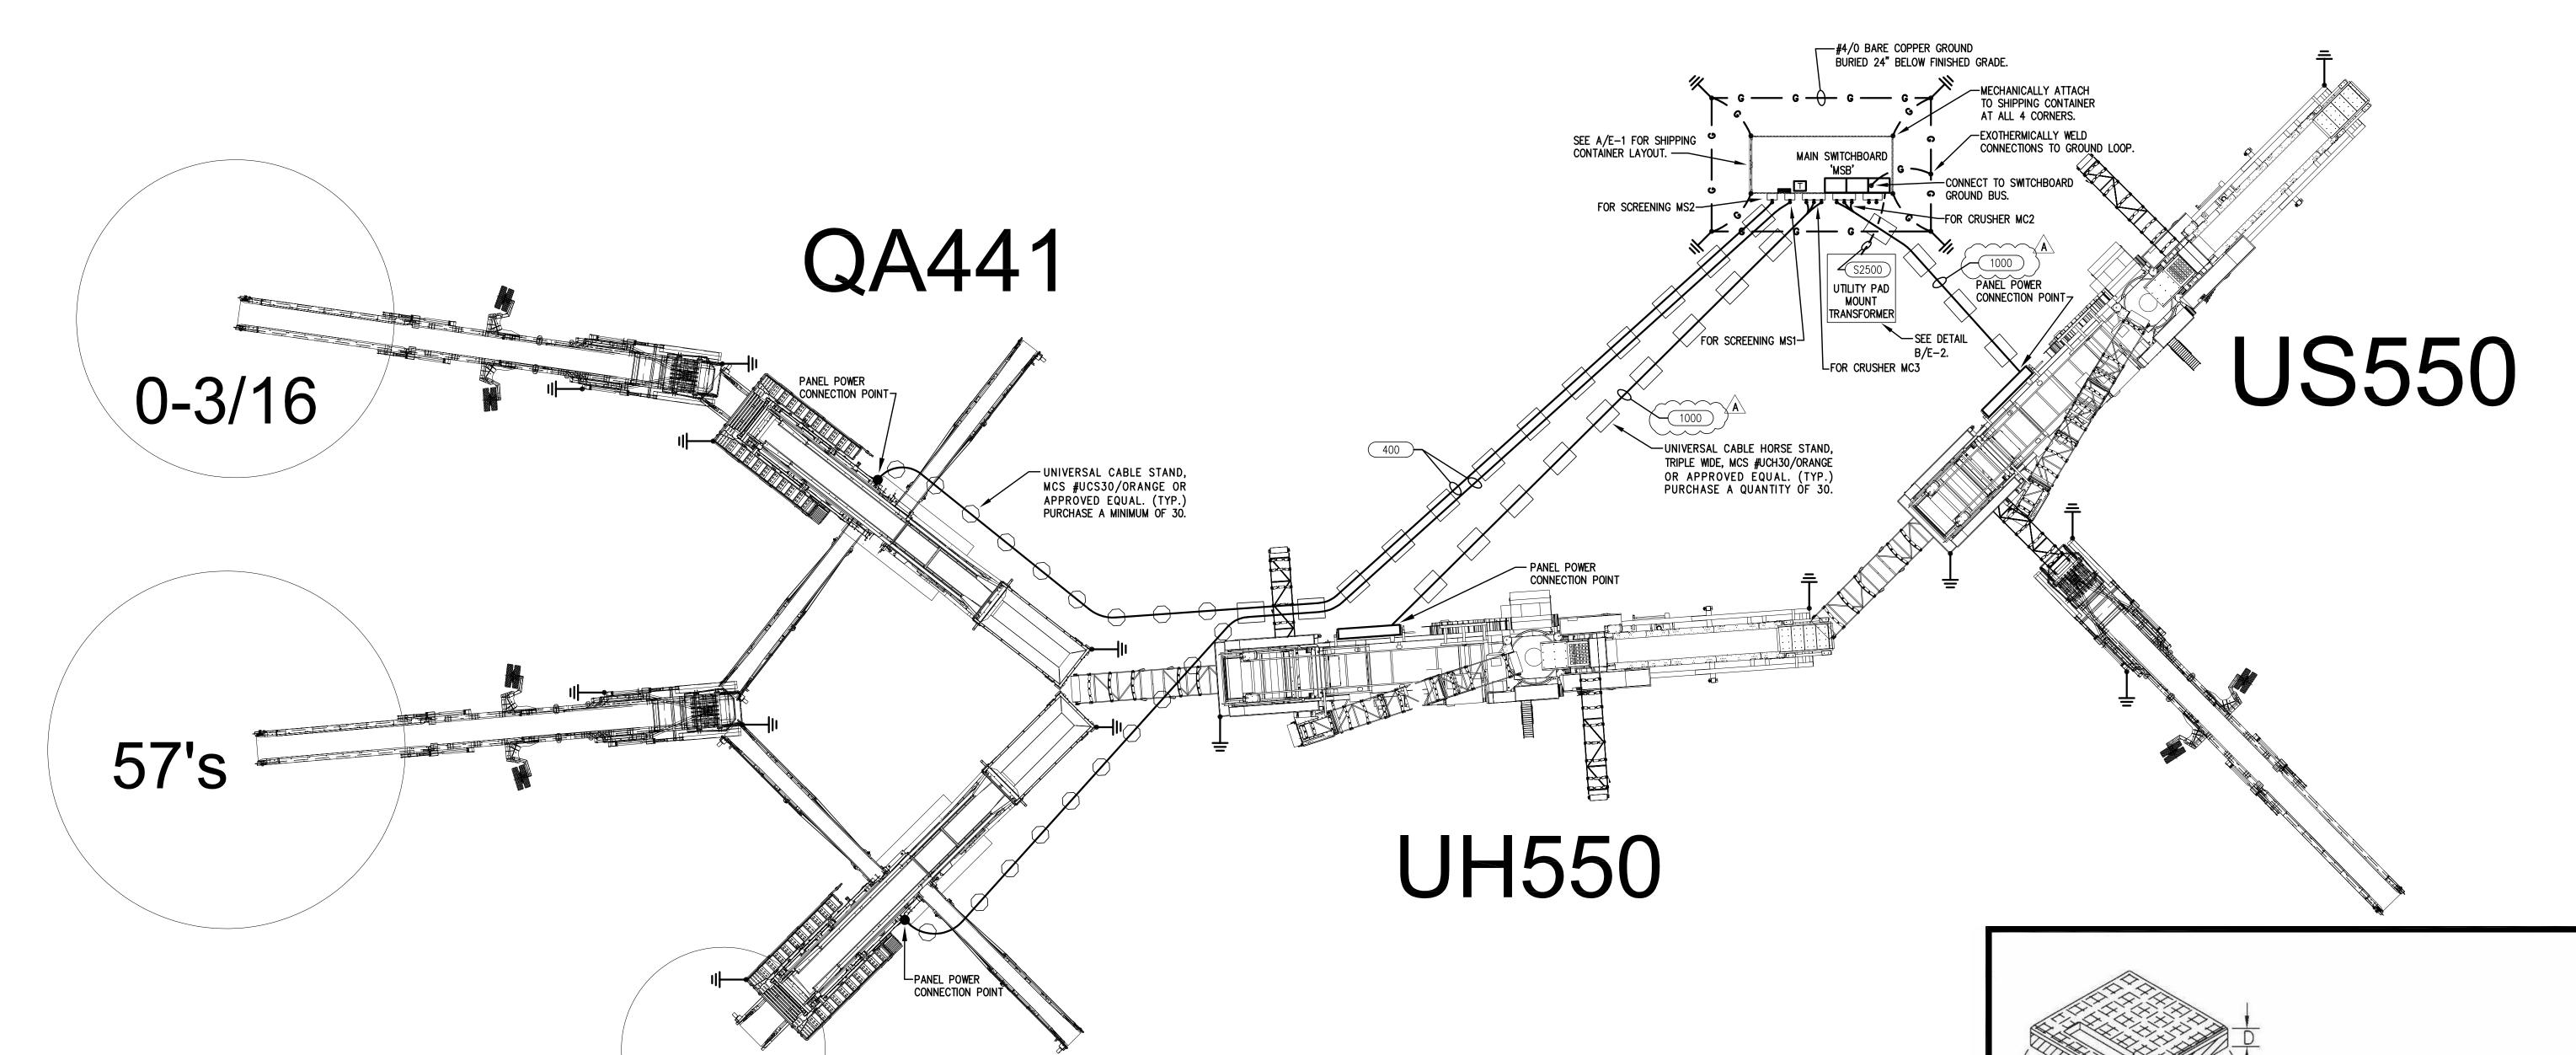

CABLE/CONDUIT SCHEDULE

400

(1000)

S2500

WIRE AND CONDUIT 4/C-500KCMIL WITH 4#1/0G, TYPE G, SOUTHWIRE RHINOFLEX CPE MINING CABLE, 90°C, SPEC 47208

3 SETS [4/C-500KCMIL WITH 4#1/0G, TYPE G, SOUTHWIRE RHINOFLEX CPE MINING CABLE, 90°C, SPEC 47208]


6 [4 #600KCMIL; 4"C]

0-3/16

1. POWER CABLES ENERGIZED TO POTENTIALS IN EXCESS OF 150 VOLTS, PHASE-TO-GROUND, SHALL NOT BE MOVED WITH EQUIPMENT UNLESS SLEDS OR SLINGS, INSULATED FROM SUCH EQUIPMENT ARE USED. WHEN SUCH ENERGIZED CABLES ARE MOVED MANUALLY, INSULATED HOOKS, TONGS, ROPES, OR SLINGS SHALL BE USED UNLESS SUITABLE PROTECTION FOR PERSONS IS PROVIDED BY OTHER MEANS. THIS DOES NOT PROHIBIT PULLING OR DRAGGING OF CABLE BY THE EQUIPMENT IT POWERS WHEN THE CABLE IS PHYSICALLY ATTACHED TO THE EQUIPMENT BY SUITABLE MECHANICAL DEVICES, AND THE CABLE IS INSULATED FROM THE EQUIPMENT.


NOTES:

- 2. CONTINUITY AND RESISTANCE OF GROUNDING SYSTEMS SHALL BE TESTED IMMEDIATELY AFTER INSTALLATION, REPAIR, AND MODIFICATION; AND ANNUALLY THEREAFTER. A RECORD OF THE RESISTANCE MEASURED DURING THE MOST RECENT TESTS SHALL BE AVAILABLE AT ALL TIMES.
- 3. AT BOTH ENDS OF TRAILING CABLES, PROVIDE STRAIN RELIEF TO PROTECT THE CABLE FROM DAMAGE AND TO PREVENT STRAIN ON THE ELECTRICAL CONNECTIONS.
- 4. SURPLUS TRAILING CABLES SHALL BE STORED IN CABLE BOATS, STORED ON REELS MOUNTED ON THE EQUIPMENT, OR OTHERWISE PROTECTED FROM MECHANICAL DAMAGE.

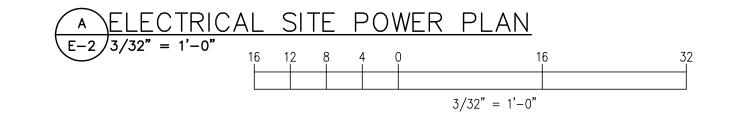

QA441



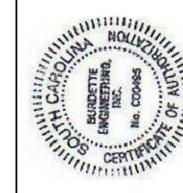

CRUSHING SERVICE

OTHER OBSTRUCTION

REINFORCING BARS

UM1-6C

TRICAL OCONEE

SHEET NUMBER

E-2

B UTILITY TRANSFORMER CONCRETE PAD DETAIL E-2 NOT TO SCALE

DATE:

JANUARY, 1992

OTHER OBSTRUCTION

TOOL OR CHAMFER EDGES

411X1111111X117

DIMENSIONS IN INCHES

CONCRETE TESTING, 4000 POUNDS PER SQUARE INCH, 4% TO 6% ENTRAINED AIR, 3/4" MAXIMUM SIZE AGGREGATE, WITH FIBER REINFORCEMENT,
 REINFORCING STEEL, ATSM-A615 GRADE 60, PLACE APPROX. 6" O.C. EACH WAY AND SECURELY TIED TOGETHER.

5. THE AREA IN FRONT OF THE TRANSFORMER PAD MUST REMAIN OPEN AND PROVIDE MECHANICAL ACCESS TO EQUIPMENT

PAD MOUNTED TRANSFORMER SPECIFICATIONS FOR SUPPORTING CONCRETE PADS

MEJ 3/2/00 MEJ 10/8/02

3. MINIMUM CONCRETE COVER OVER REMFORCING STEEL 2 INCHES UNLESS NOTED.
4. WOOD FLOAT FINISH, LEAVING NO DEPRESSIONS.

MEJ 11/15/00

INSTALLED.

6. COMOUNT ON SECONDARY SIDE SHOULD BE EVEN WITH CONCRETE PAD.

KVA A B C D E F MK1 MK2 MK3 MK4 MK5
45, 75, 112.5 80 80 10 8 50 20 7 #4 6 #4 6 #4 6 #4 4 #4

2 OF 3 SHEETS